


Plan 1, Overview 2008 Boundary Proposal

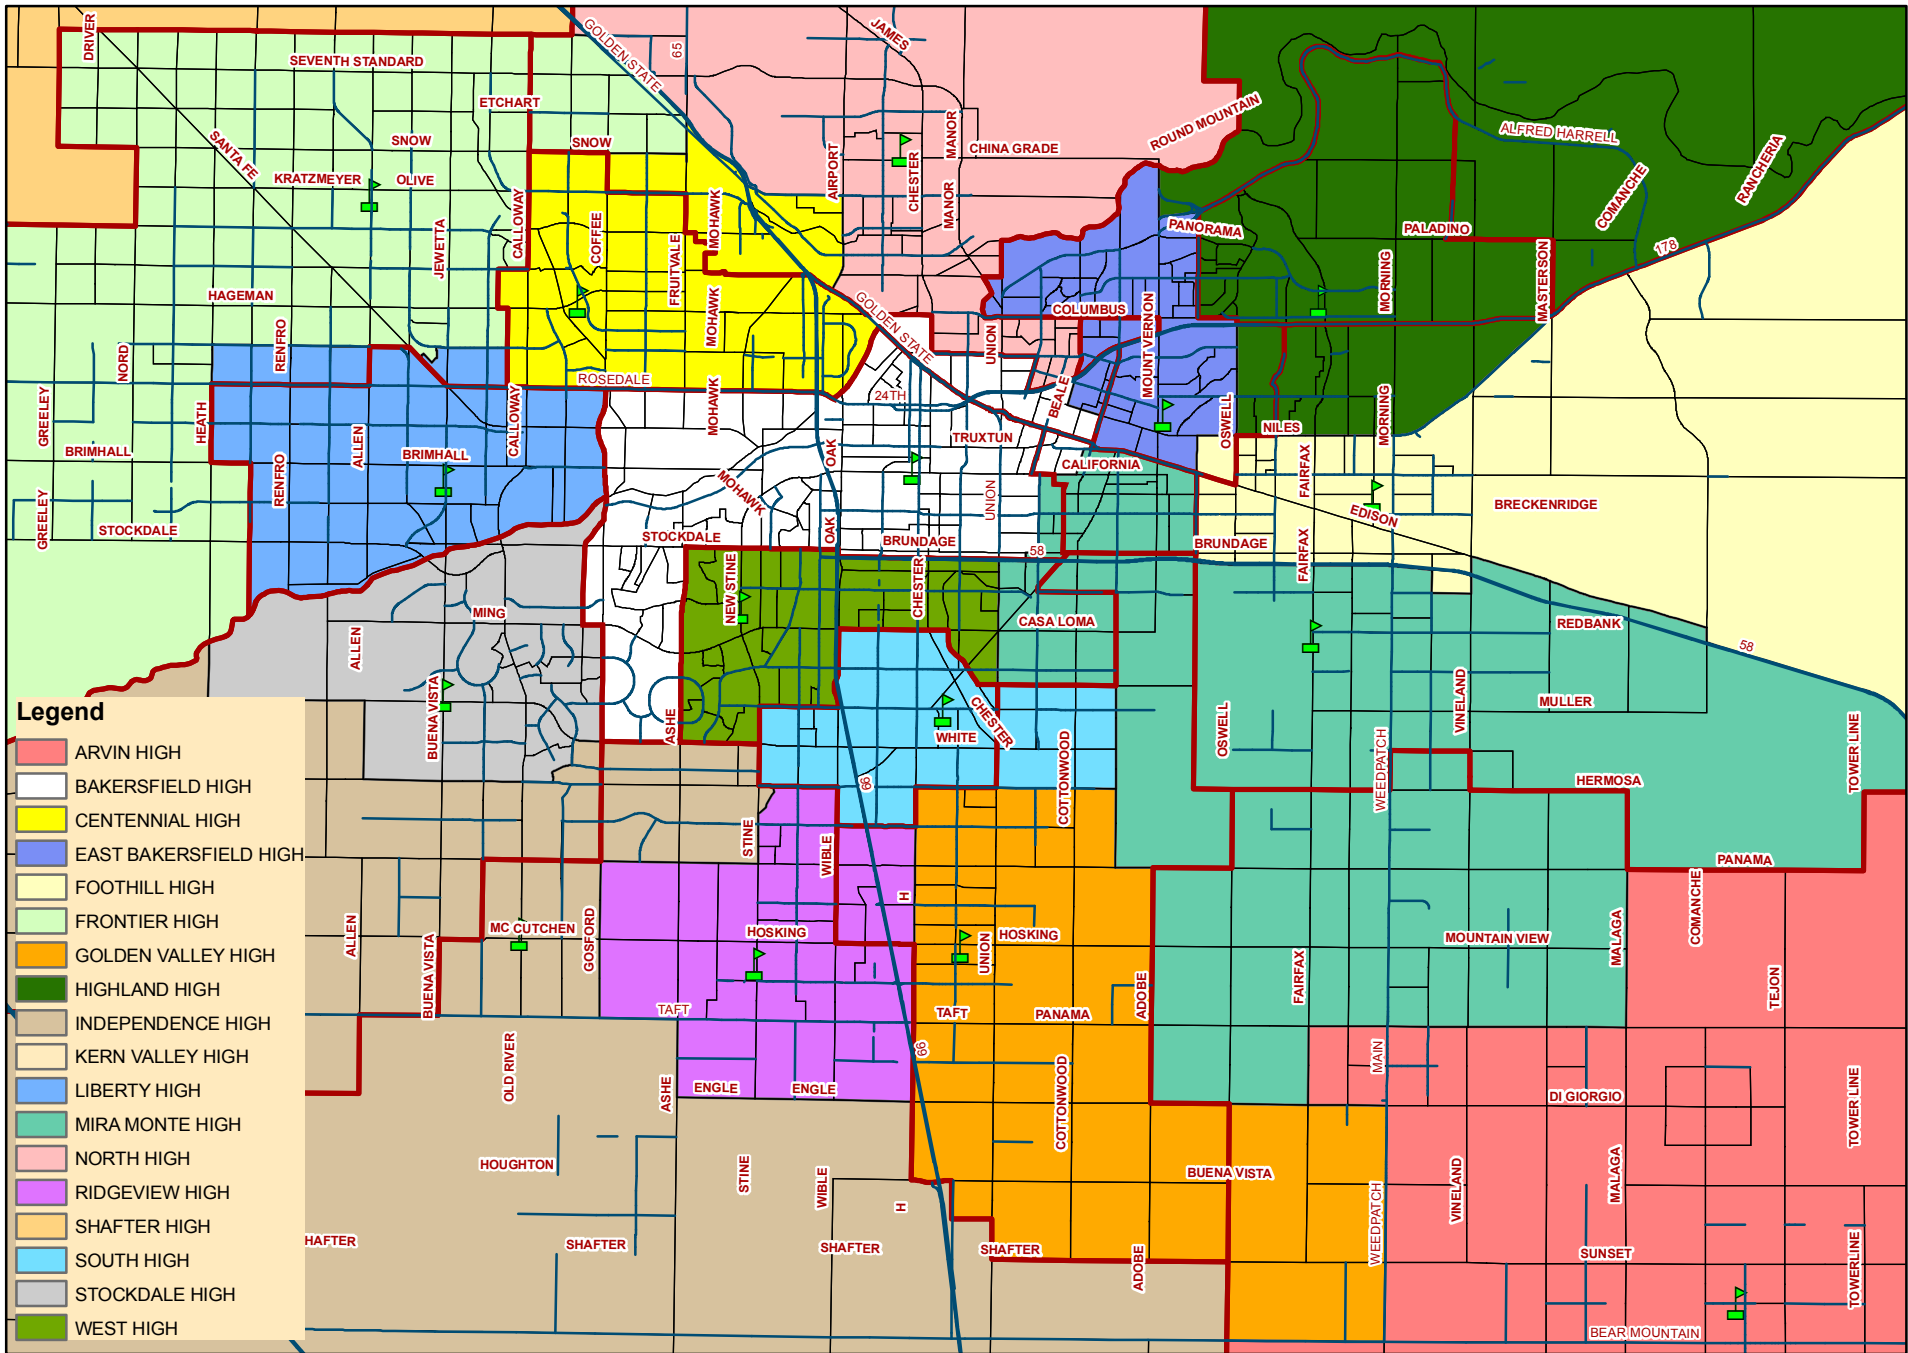

Red Lines Show Current Boundaries